


HUNGRY BOARDS
AS BUILT – BULLY BOY
SECTIONAL VIEW



TYPICAL STANCHION
SCALE 2:1

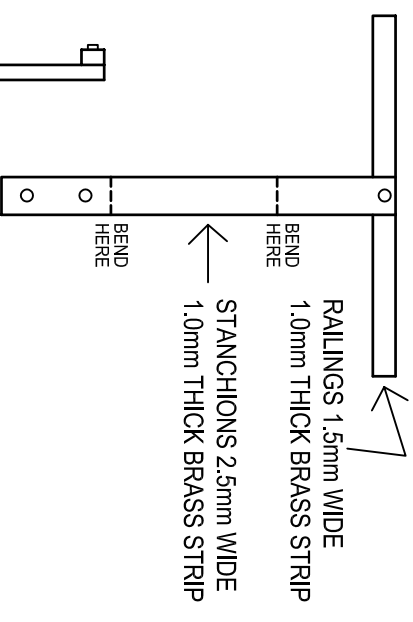