


REAR CAB WALL

TENDER SIDES

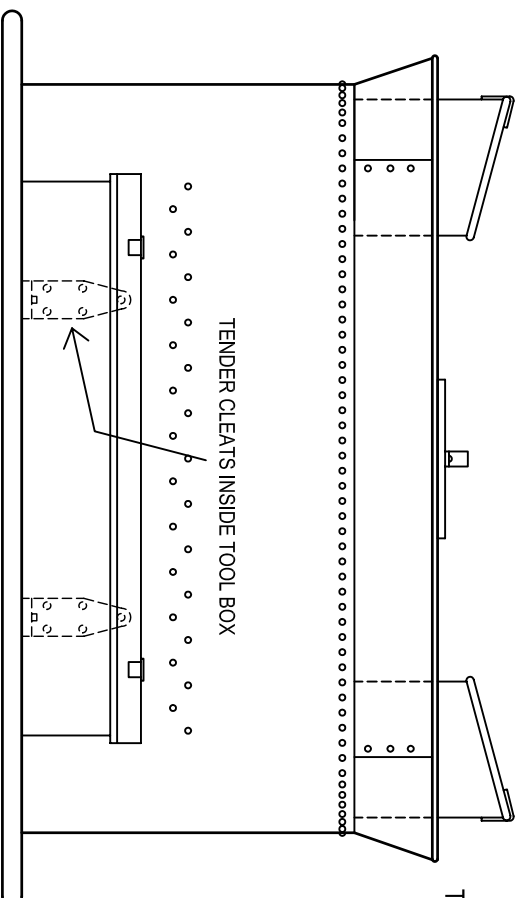

TENDER REAR

TOOL BOXES ON TENDER
AS BUILT- SHORT TENDER ONLY
3NO. TOOL BOXES
ONE ON REAR, TWO ON TOP

TOP TOOL BOXES REQUIRED ON-
2-6-6T, BULLY BOY,
PEACH BOTTOM #3, AA DENNY.

